

FLOOR FRAME LAYOUT - Ground floor
SCALE 1:100

* Trim floor, insert new floor joists under new walls and patch flooring.

AMENDED FINAL CONSTRUCTION - 22.09.16

MARK-UP A

FOR: MR. P & MRS. J LEVETT

FINAL CONSTRUCTION - 21.09.16


PREPARED - 22.9.16 cs
PREPARED - 22.8.16 cs
PREPARED - 2.8.16 ap

SHEET: 1 OF 12

AT: 14 YETHONGA AVE, LANE COVE. NSW. 2066.

JOB NO: 7744/16 D


Cape Cod
AUSTRALIA

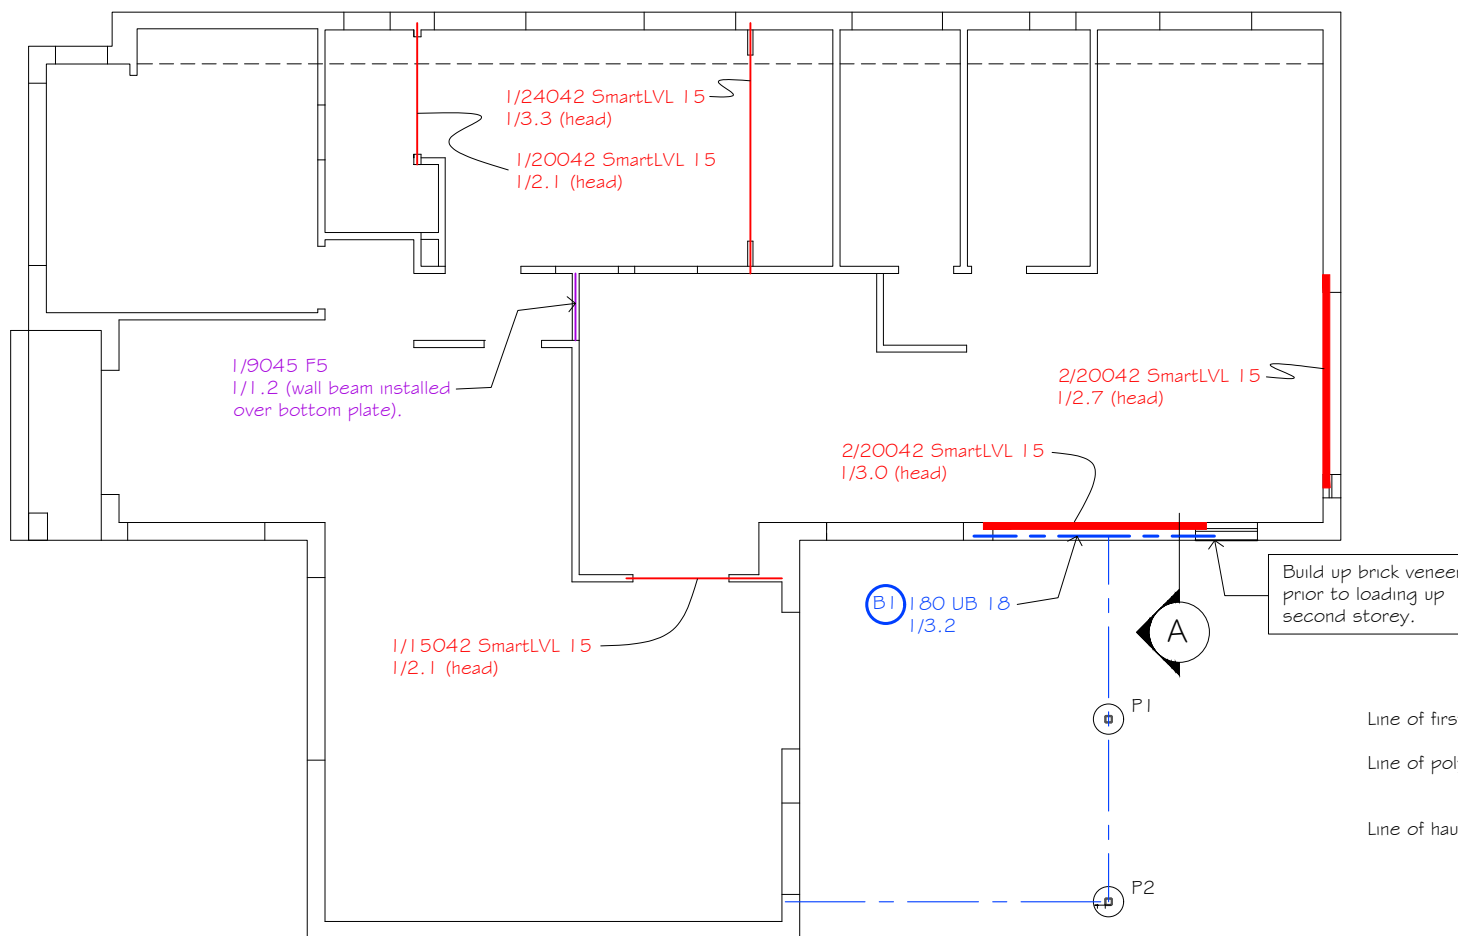

WALL FRAME LAYOUT

SCALE 1:100

- * Min. 90x45 F5 studs at 450mm centres.
- * P1 - P2 - 89x89x5mm galvanised SHS set on concrete pad footing to eng. details.
Site weld to B7.
- * Provide 2/100x10mm by 250mm long steel bearing plates to both ends of B1.

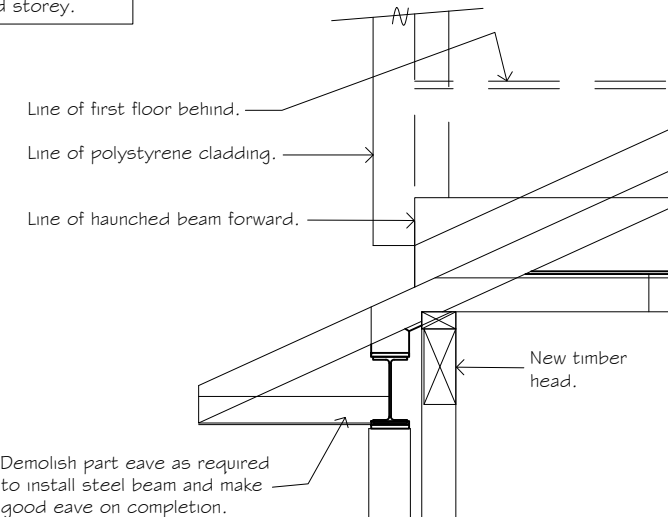

DETAIL A 1:20

AMENDED FINAL CONSTRUCTION - 22.09.16

FOR: MR. P & MRS. J LEVETT

FINAL CONSTRUCTION - 21.09.16

PREPARED - 22.9.16 cs
PREPARED - 22.8.16 cs
PREPARED - 2.8.16 ap


SHEET: 2 OF 12


AT: 14 YETHONGA AVE, LANE COVE. NSW. 2066.

JOB NO: 7744/16


D

Cape Cod
AUSTRALIA

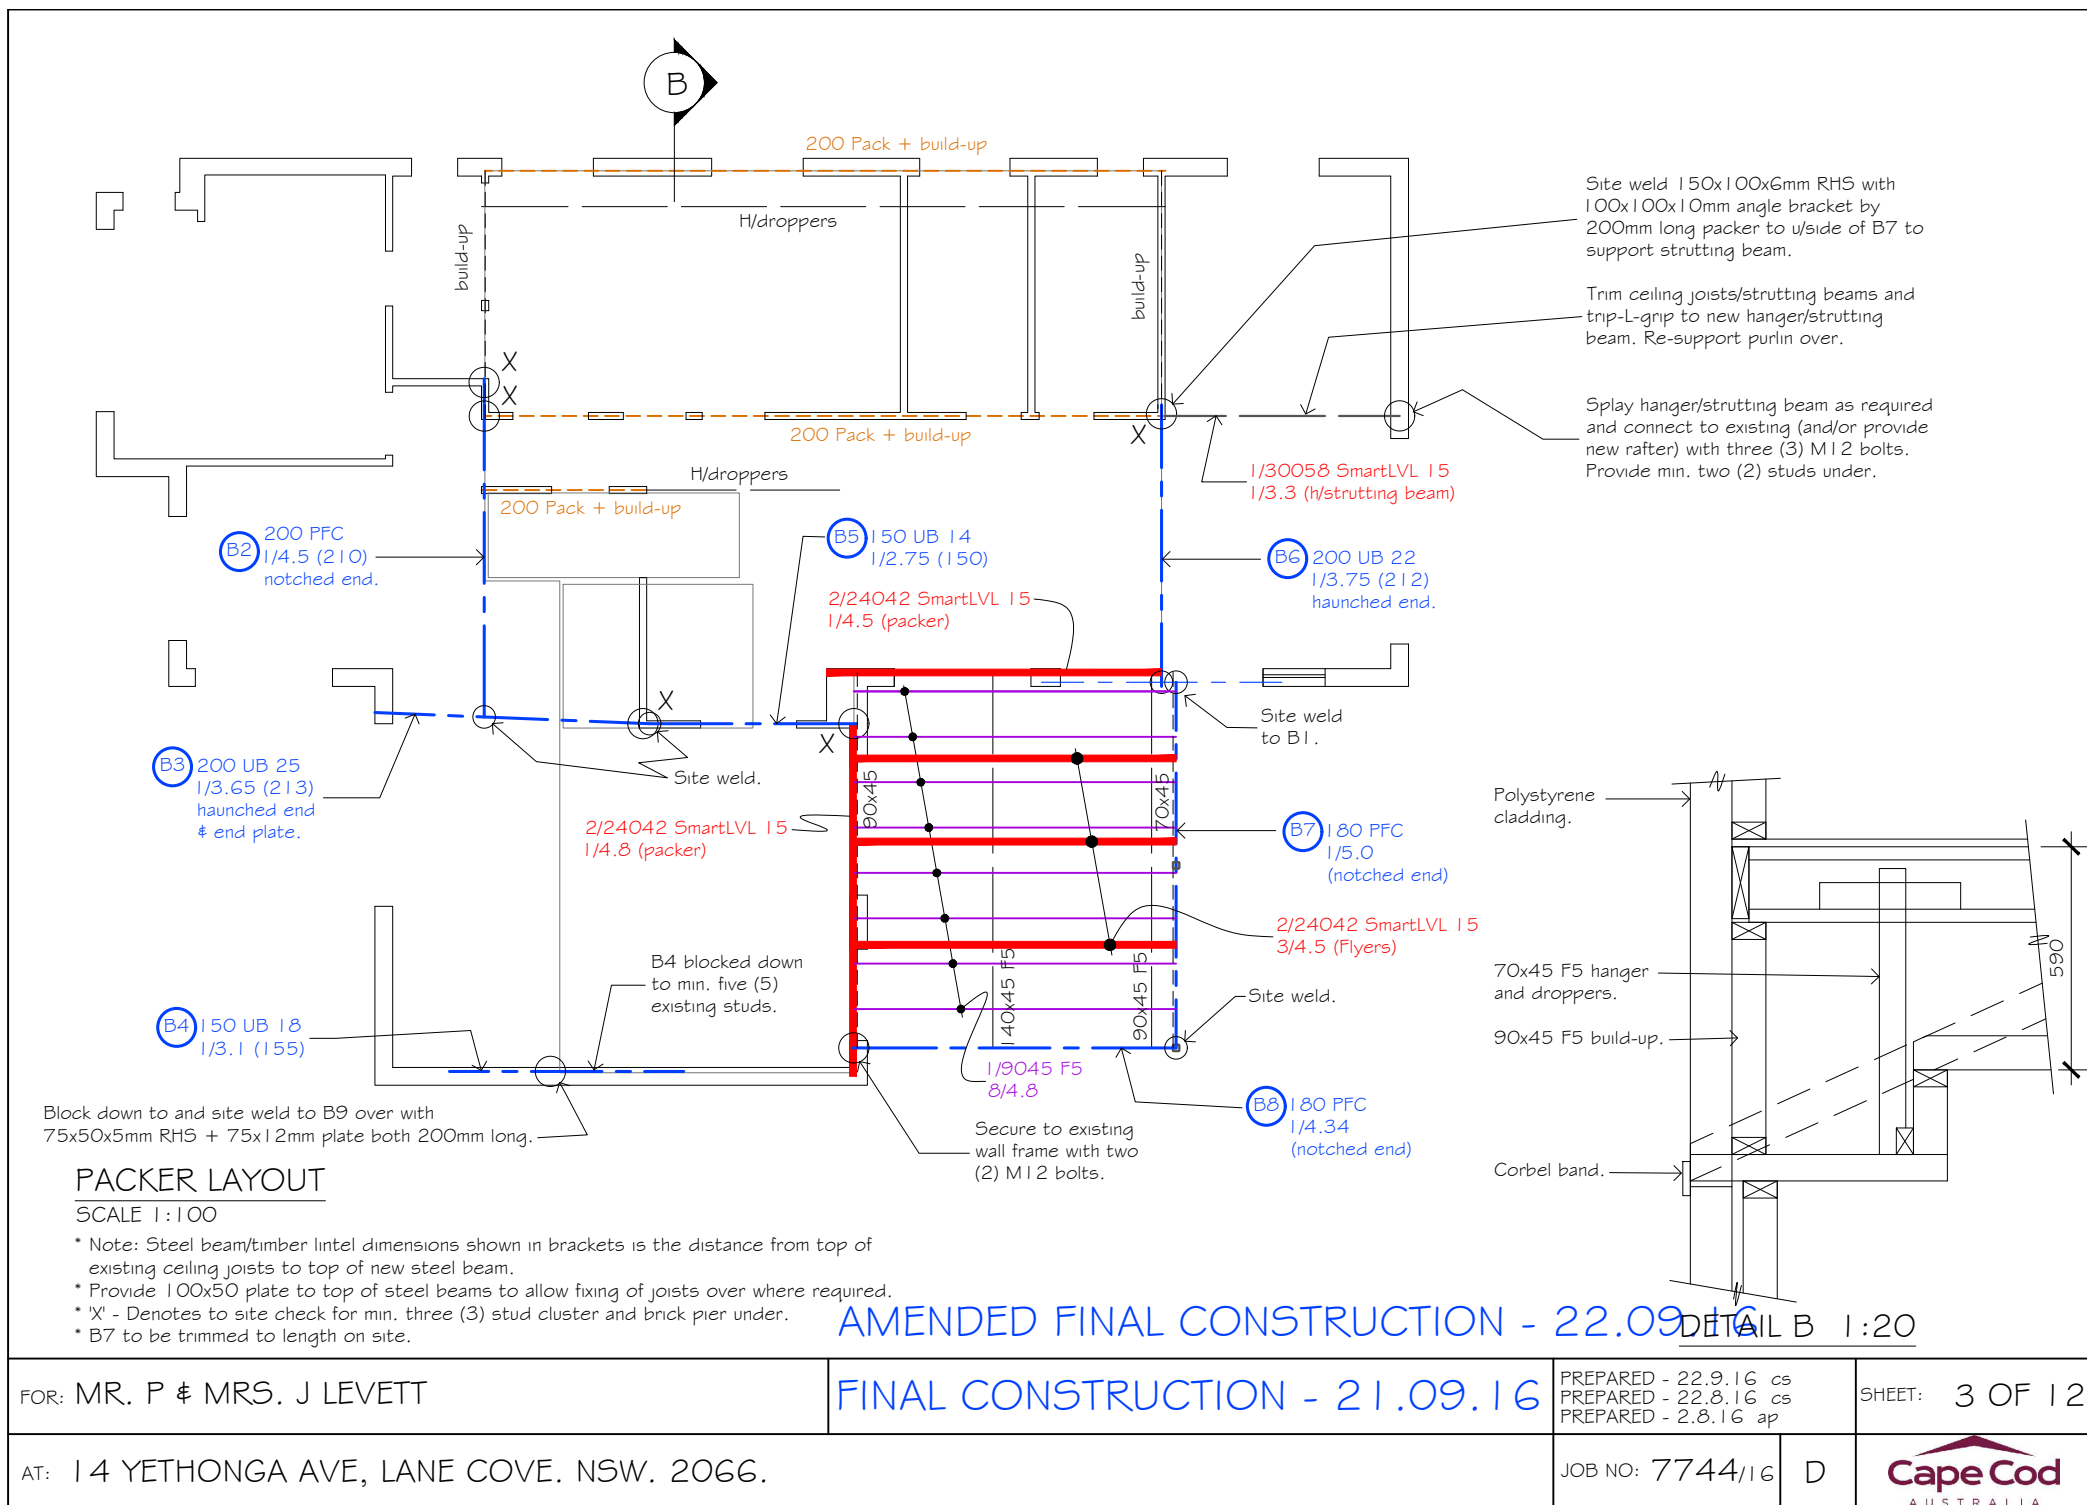

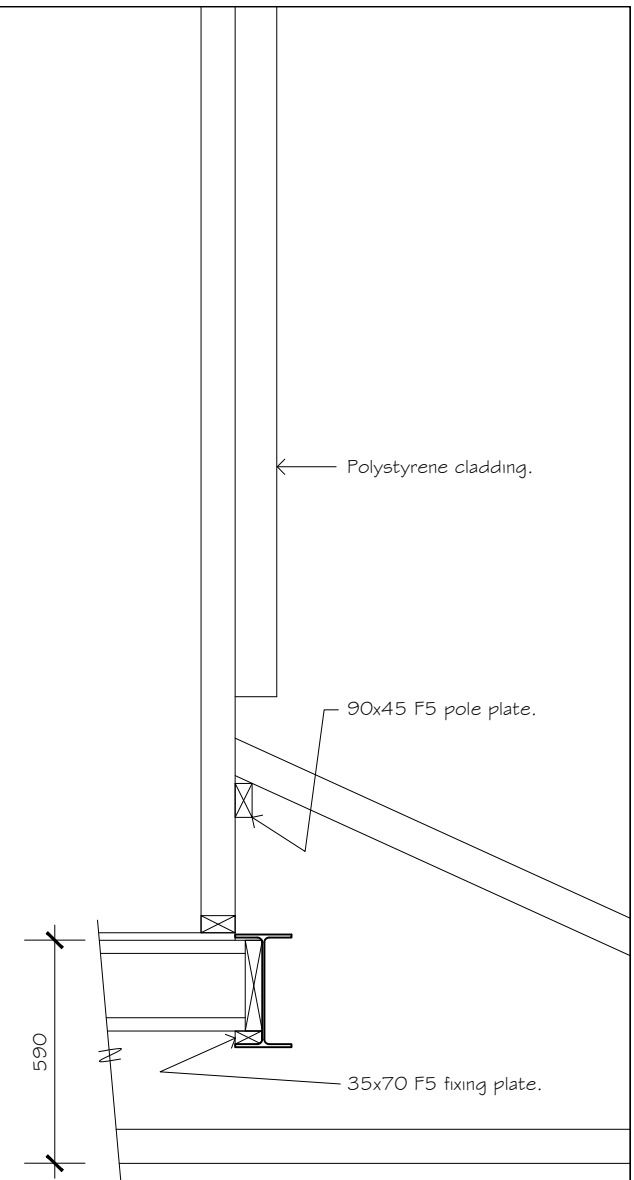

Cape Cod
AUSTRALIA

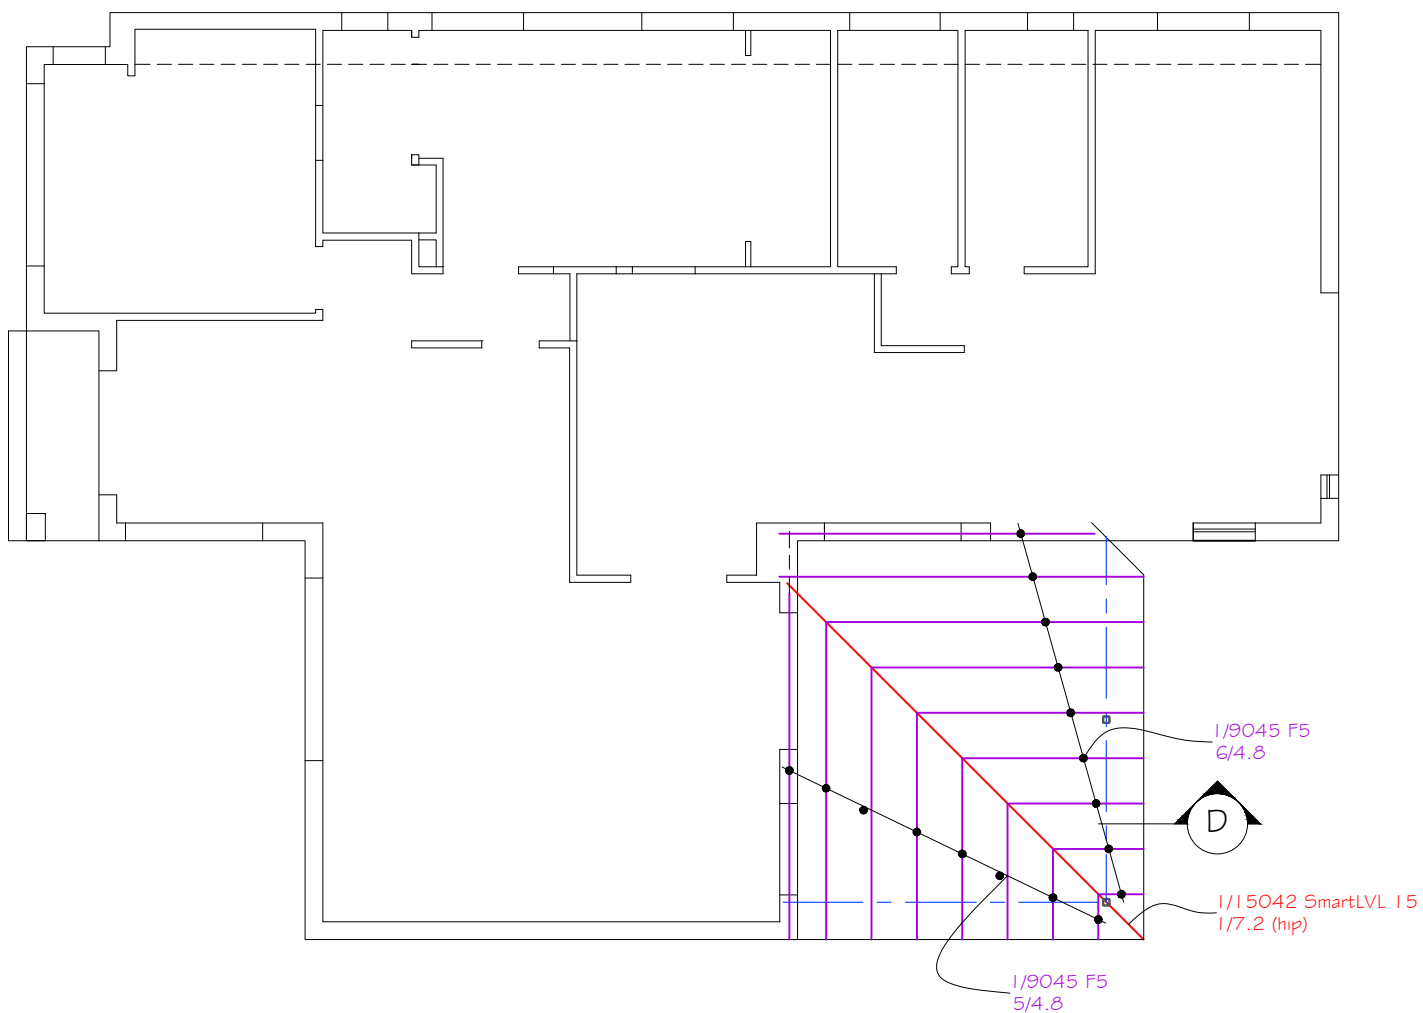

RAFTER LAYOUT - Ground Floor

SCALE 1:100

- * Rafters at 600mm centres.
- * LVL - Denotes tiling smart lvl

AMENDED FINAL CONSTRUCTION - 22.09.16

FOR: MR. P & MRS. J LEVETT

FINAL CONSTRUCTION - 21.09.16

PREPARED - 22.9.16 cs
PREPARED - 22.8.16 cs
PREPARED - 2.8.16 ap


SHEET: 5 OF 12

AT: 14 YETHONGA AVE, LANE COVE. NSW. 2066.

JOB NO: 7744/16

D

Cape Cod
AUSTRALIA

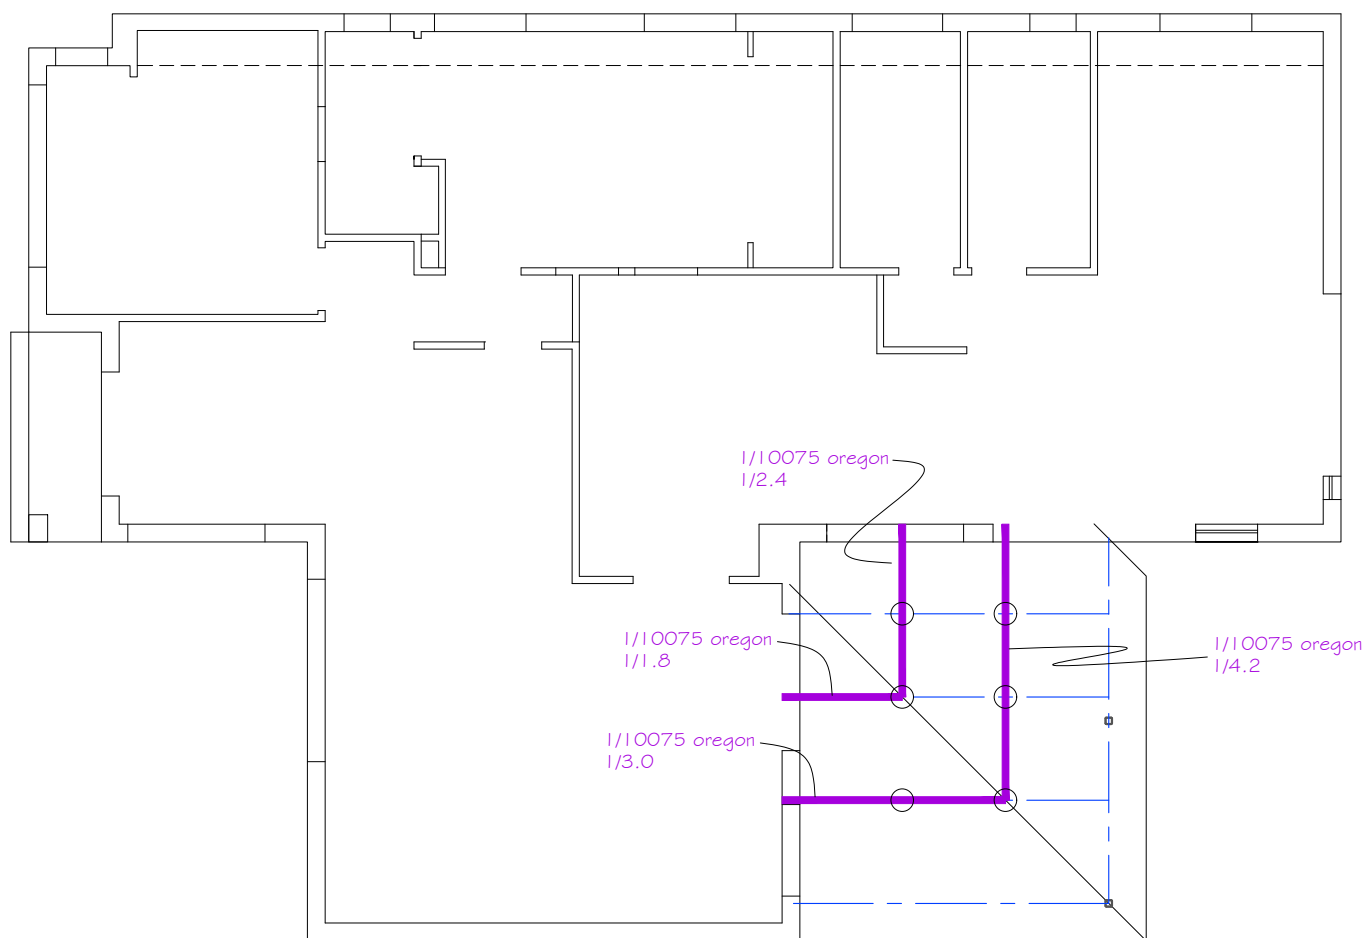

PURLIN LAYOUT

SCALE 1:100

- 100x75mm oregon purlins laid in continuous lengths at max. 1500mm centres.
- 100x75mm oregon struts.
- 90x45 F5 collar ties at 1200mm centres.

AMENDED FINAL CONSTRUCTION - 22.09.16

FOR: MR. P & MRS. J LEVETT

FINAL CONSTRUCTION - 21.09.16

PREPARED - 22.9.16 cs
PREPARED - 22.8.16 cs
PREPARED - 2.8.16 ap


SHEET: 6 OF 12

AT: 14 YETHONGA AVE, LANE COVE. NSW. 2066.

JOB NO: 7744/16

D

Cape Cod
AUSTRALIA

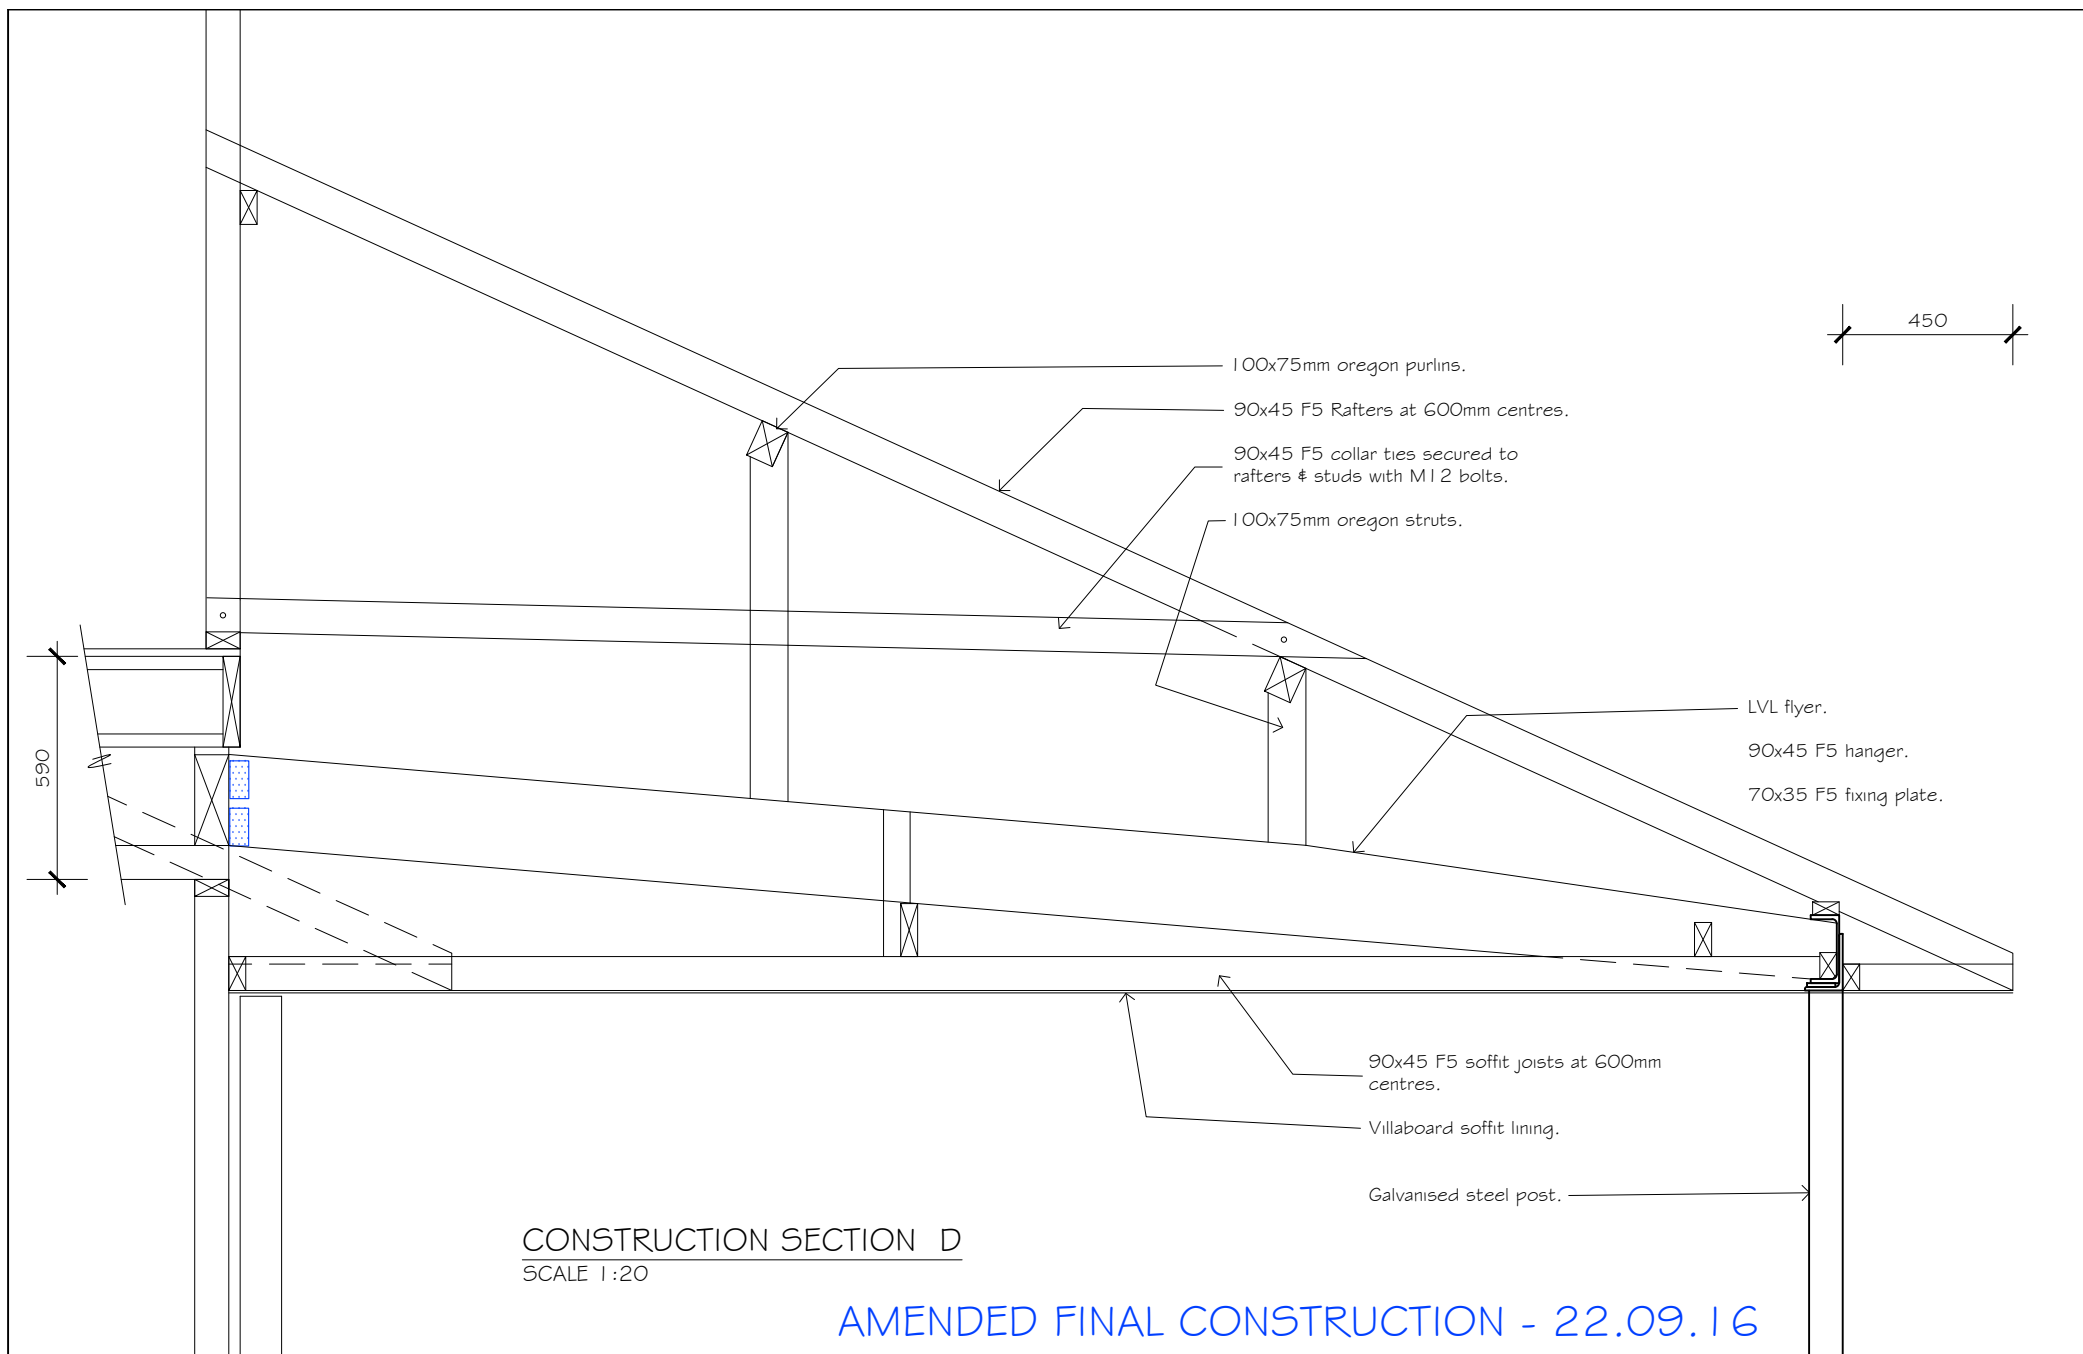

FOR: MR. P & MRS. J LEVETT

FINAL CONSTRUCTION - 21.09.16

PREPARED - 22.9.16 cs
PREPARED - 22.8.16 cs
PREPARED - 2.8.16 ap



SHEET: 7 OF 12

AT: 14 YETHONGA AVE, LANE COVE. NSW. 2066.


JOB NO: 7744/16

D

Cape Cod
AUSTRALIA

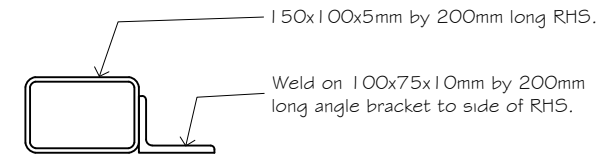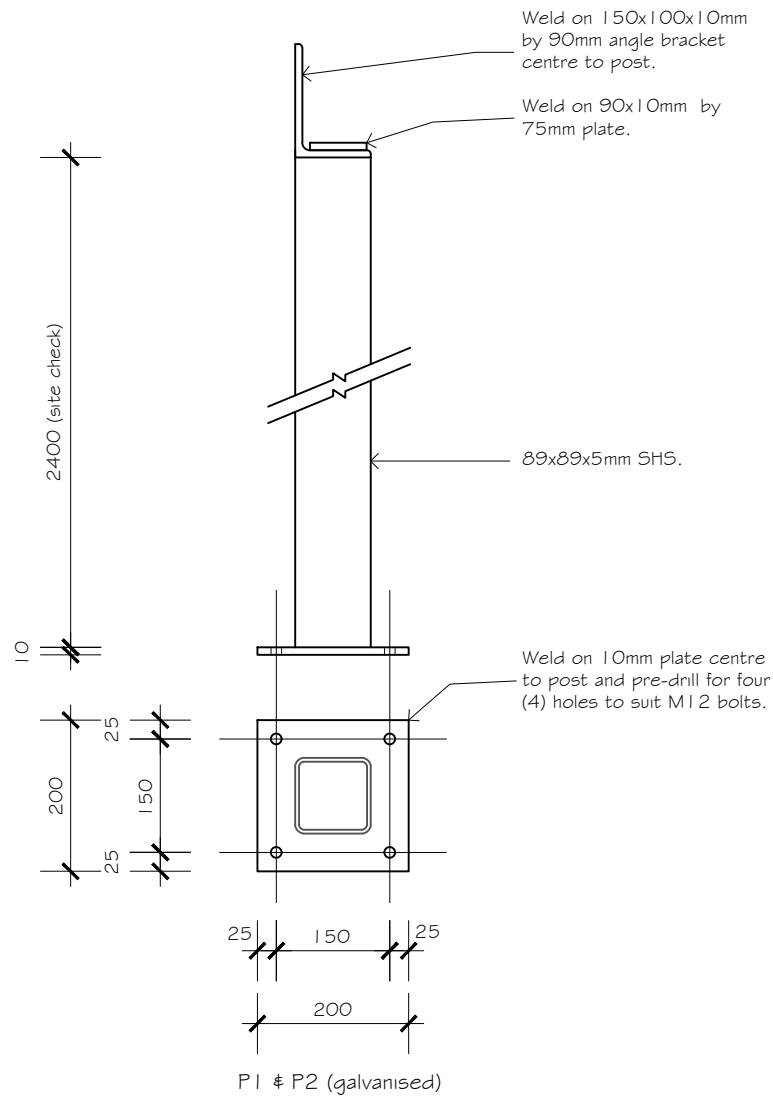

PACKER

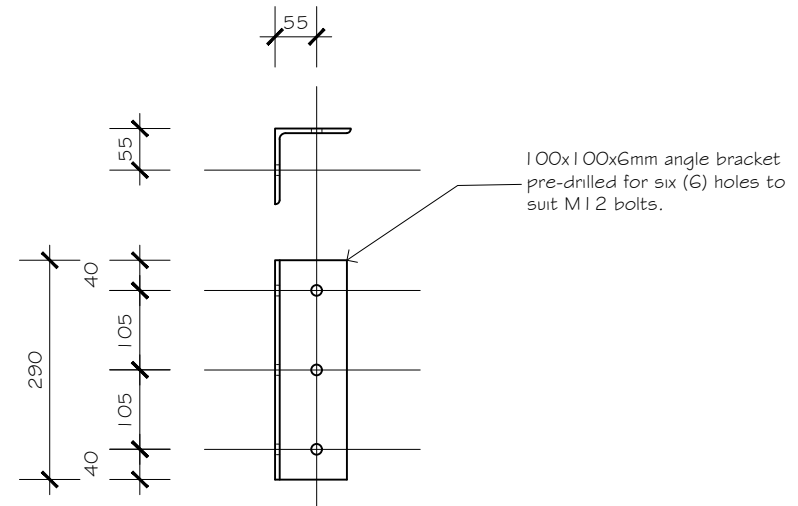

BRACKET (2 off)

STEELWORK DETAILS 1:10

AMENDED FINAL CONSTRUCTION - 22.09.16

FOR: MR. P & MRS. J LEVETT

FINAL CONSTRUCTION - 21.09.16

PREPARED - 22.9.16 cs
PREPARED - 22.8.16 cs
PREPARED - 2.8.16 ap


SHEET: 8 OF 12

AT: 14 YETHONGA AVE, LANE COVE. NSW. 2066.

JOB NO: 7744/16

D

Cape Cod
AUSTRALIA

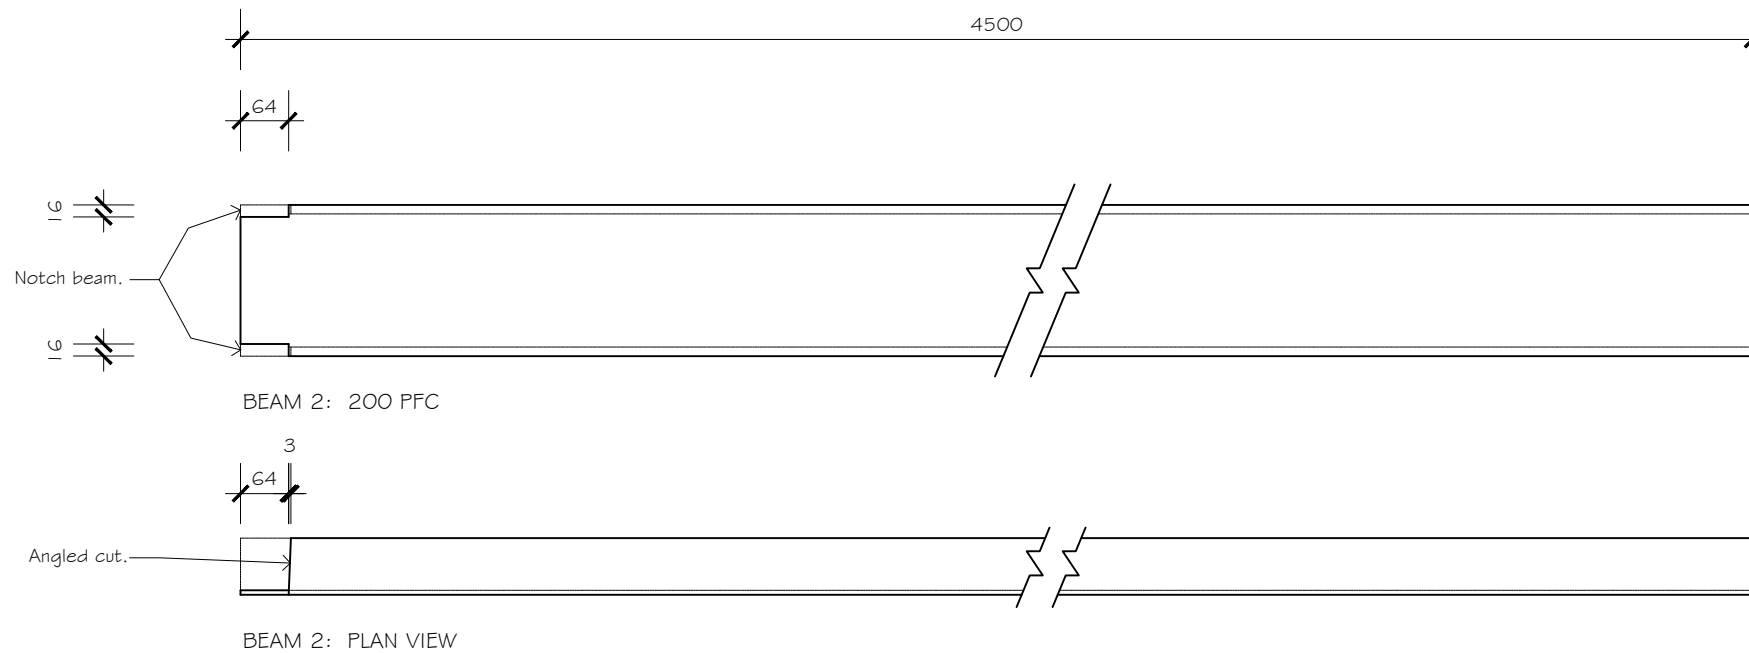

STEELWORK DETAILS 1:10

AMENDED FINAL CONSTRUCTION - 22.09.16

FOR: MR. P & MRS. J LEVETT

FINAL CONSTRUCTION - 21.09.16

PREPARED - 22.9.16 cs
PREPARED - 22.8.16 cs
PREPARED - 2.8.16 ap


SHEET: 9 OF 12

AT: 14 YETHONGA AVE, LANE COVE. NSW. 2066.


JOB NO: 7744/16

D


Cape Cod
AUSTRALIA

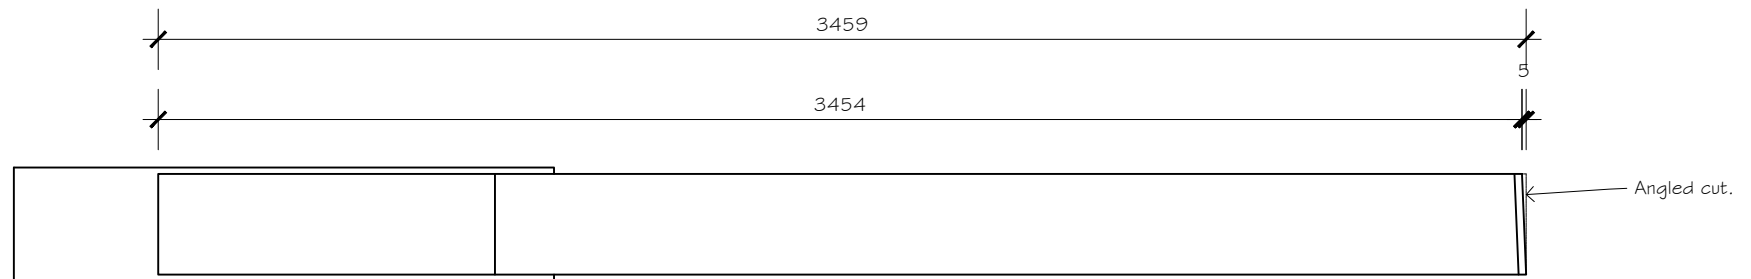

BEAM 3: PLAN VIEW

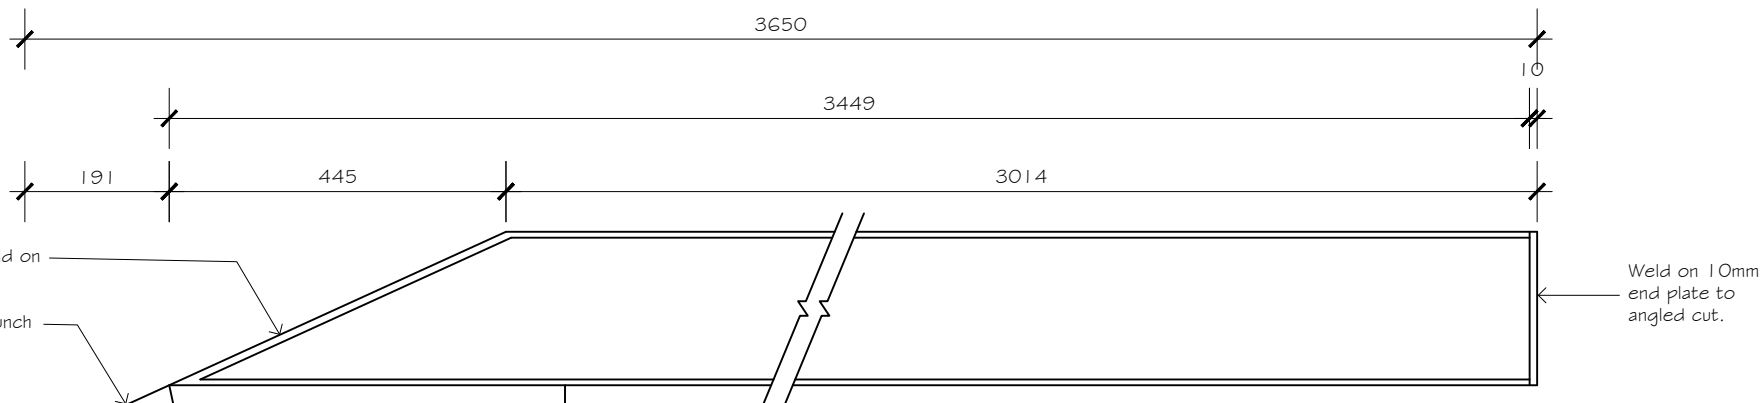

BEAM 3: 200 UB 25

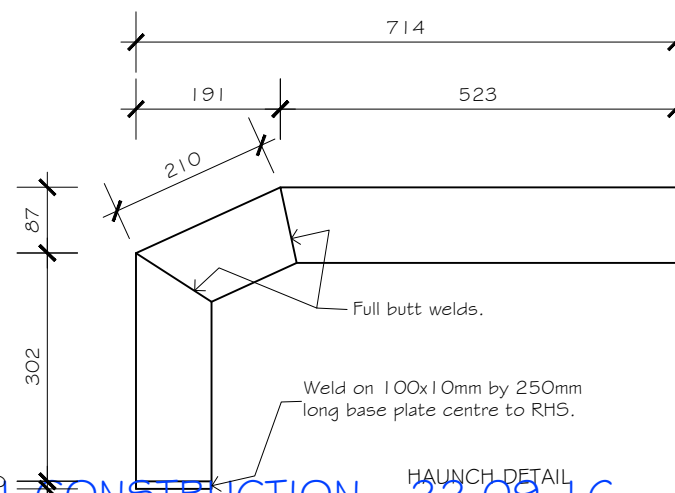

HAUNCH DETAIL

STEELWORK DETAILS 1:10

AMENDED FINAL CONSTRUCTION - 22.09.16

FOR: MR. P & MRS. J LEVETT

FINAL CONSTRUCTION - 21.09.16

PREPARED - 22.9.16 cs
PREPARED - 22.8.16 cs
PREPARED - 2.8.16 ap



SHEET: 10 OF 12

AT: 14 YETHONGA AVE, LANE COVE. NSW. 2066.

JOB NO: 7744/16

D

Cape Cod
AUSTRALIA

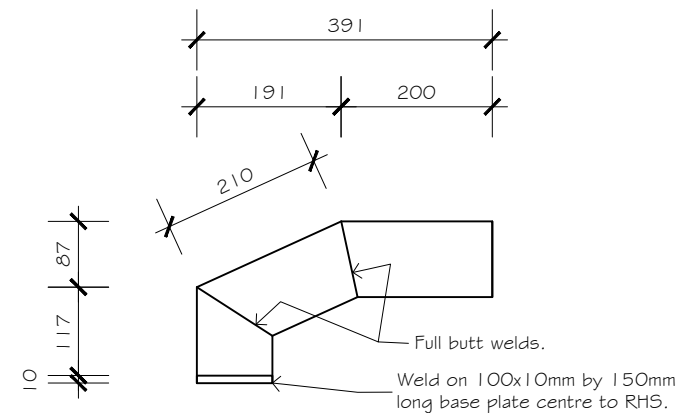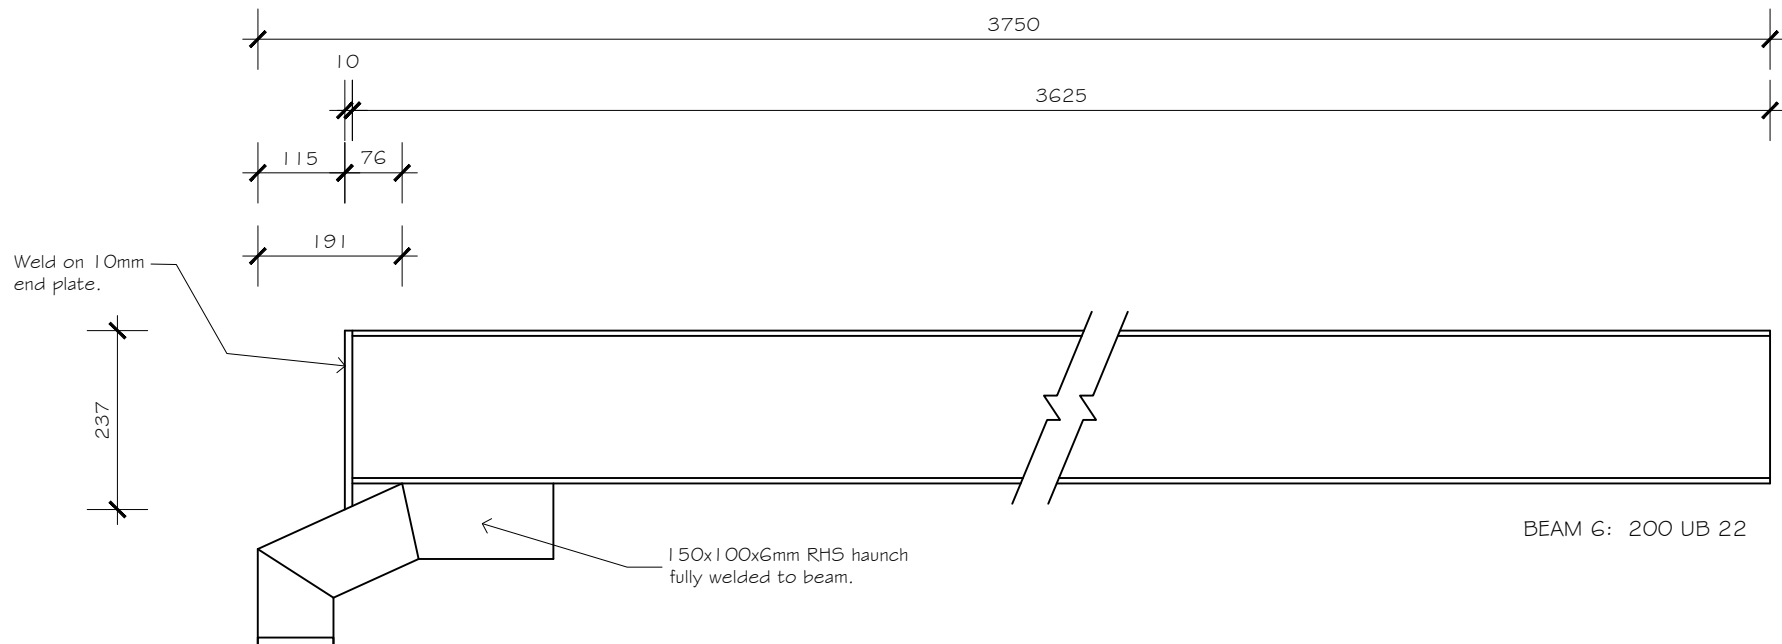

STEELWORK DETAILS 1:10

AMENDED FINAL CONSTRUCTION - 22.09.16

FOR: MR. P & MRS. J LEVETT

FINAL CONSTRUCTION - 21.09.16

PREPARED - 22.9.16 cs
PREPARED - 22.8.16 cs
PREPARED - 2.8.16 ap



SHEET: 11 OF 12

AT: 14 YETHONGA AVE, LANE COVE. NSW. 2066.

JOB NO: 7744/16

D

Cape Cod
AUSTRALIA

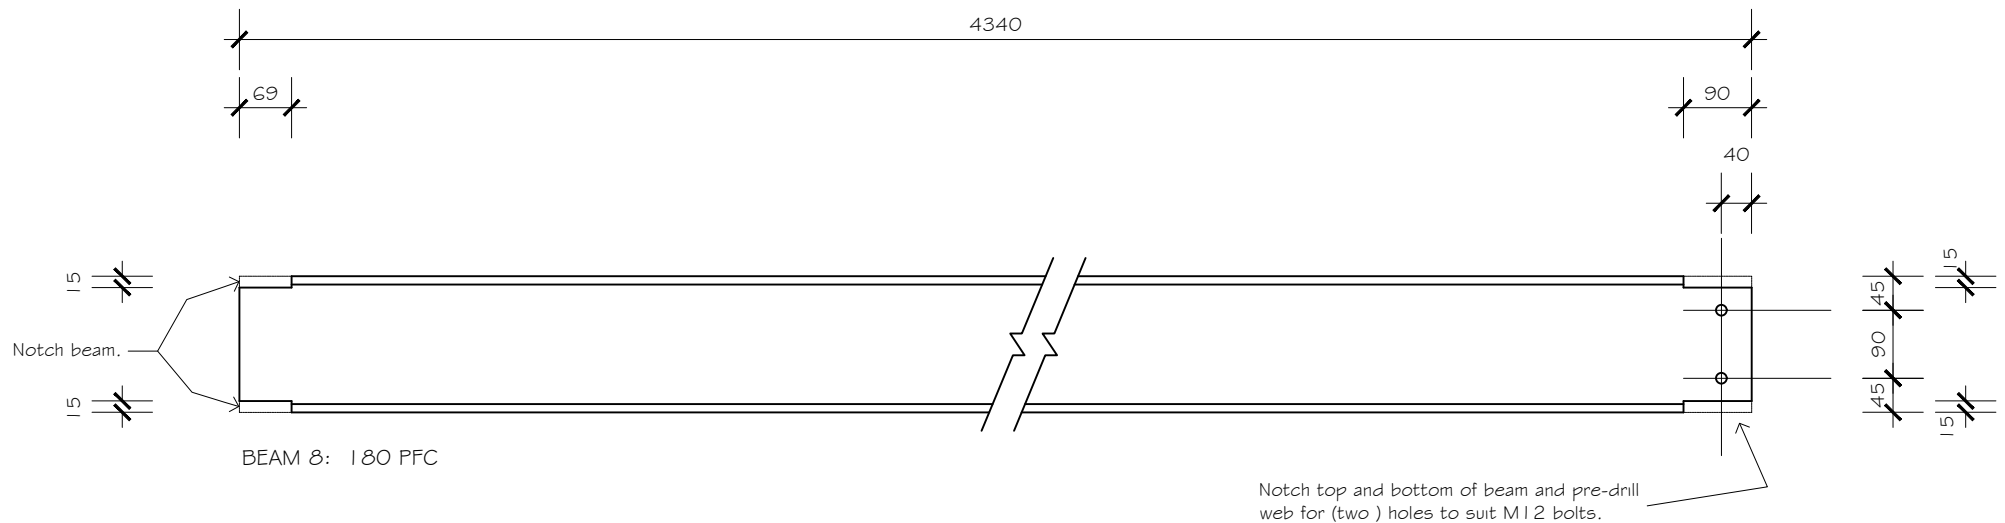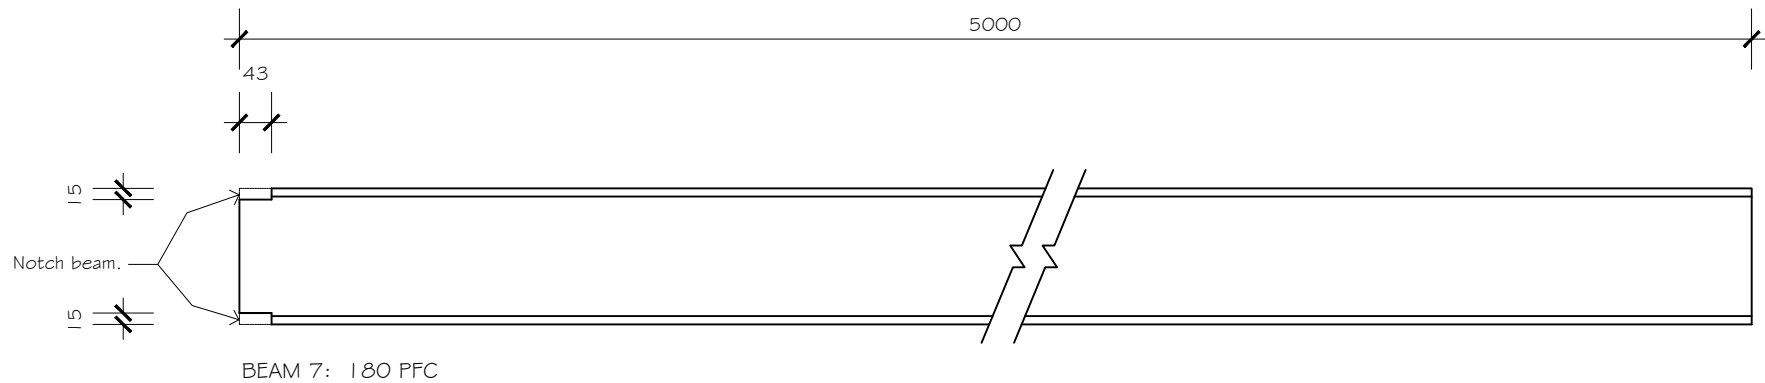

STEELWORK DETAILS 1:10

AMENDED FINAL CONSTRUCTION - 22.09.16

FOR: MR. P & MRS. J LEVETT

FINAL CONSTRUCTION - 21.09.16

PREPARED - 22.9.16 cs
PREPARED - 22.8.16 cs
PREPARED - 2.8.16 ap

SHEET: 12 OF 12

AT: 14 YETHONGA AVE, LANE COVE. NSW. 2066.

JOB NO: 7744/16

D

Cape Cod
AUSTRALIA